


B STAGE
SCALE: 1/4" = 1'-0"

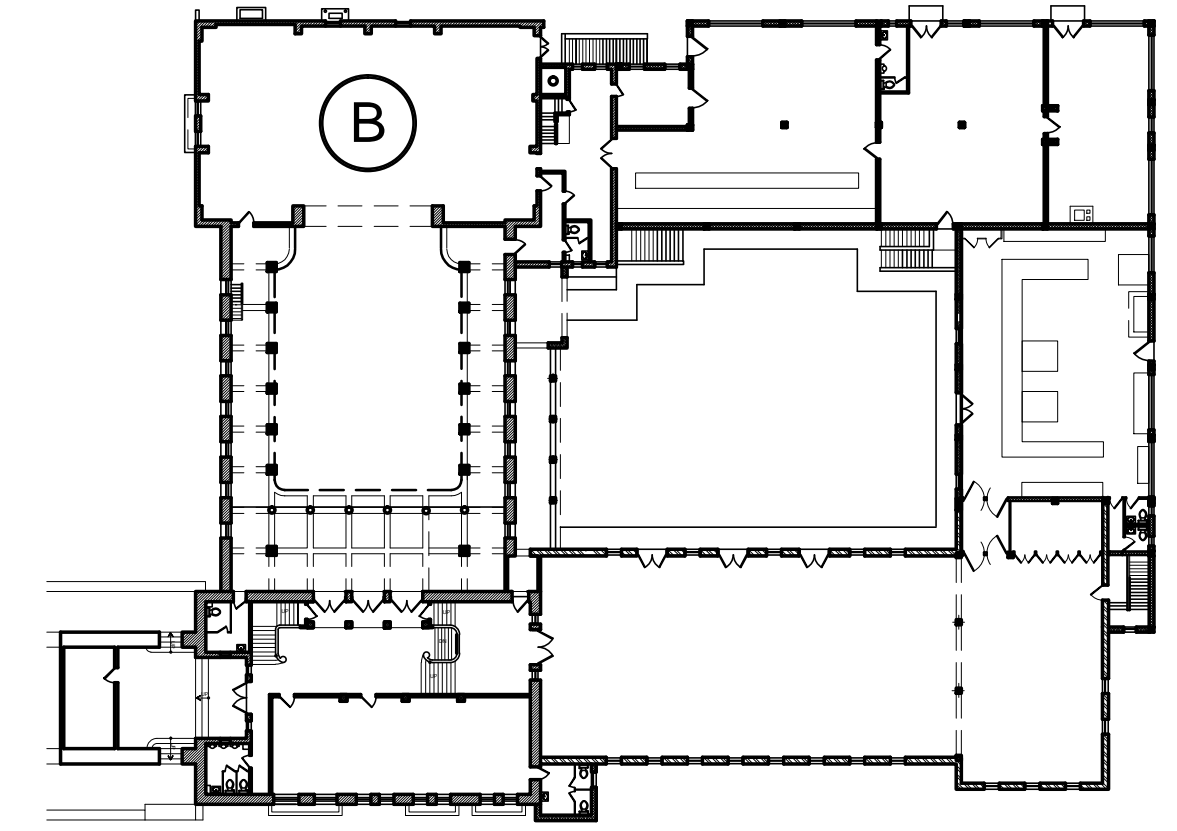

PLAN KEY

WALL LEGEND

	ORIGINAL - 1911
	ADDITION - 1955
	ADDITIONS - POST 1955

0 4 8'
SCALE IN FEET

Dale F. Zinn and Associates, Architects
P.O. Box 756
Santa Fe, New Mexico 87504
(505) 982-8690
DFZinn@aol.com

AS-BUILT LAYOUT
SCOTTISH RITE TEMPLE
463 PASEO DE PERALTA
SANTA FE COUNTY
SANTA FE, NEW MEXICO

FLOOR PLAN
STAGE

DATE:	09/01/15	LA	DZ
DRAWN BY:			
CHECKED:			
FILE:	S-R_TEMPLE-01.DWG		

REVISIONS:	ID	DESC.	DATE

SHEET
MT1a