



A DINING ROOM FLOOR PLAN
SCALE: 1/4" = 1'-0"

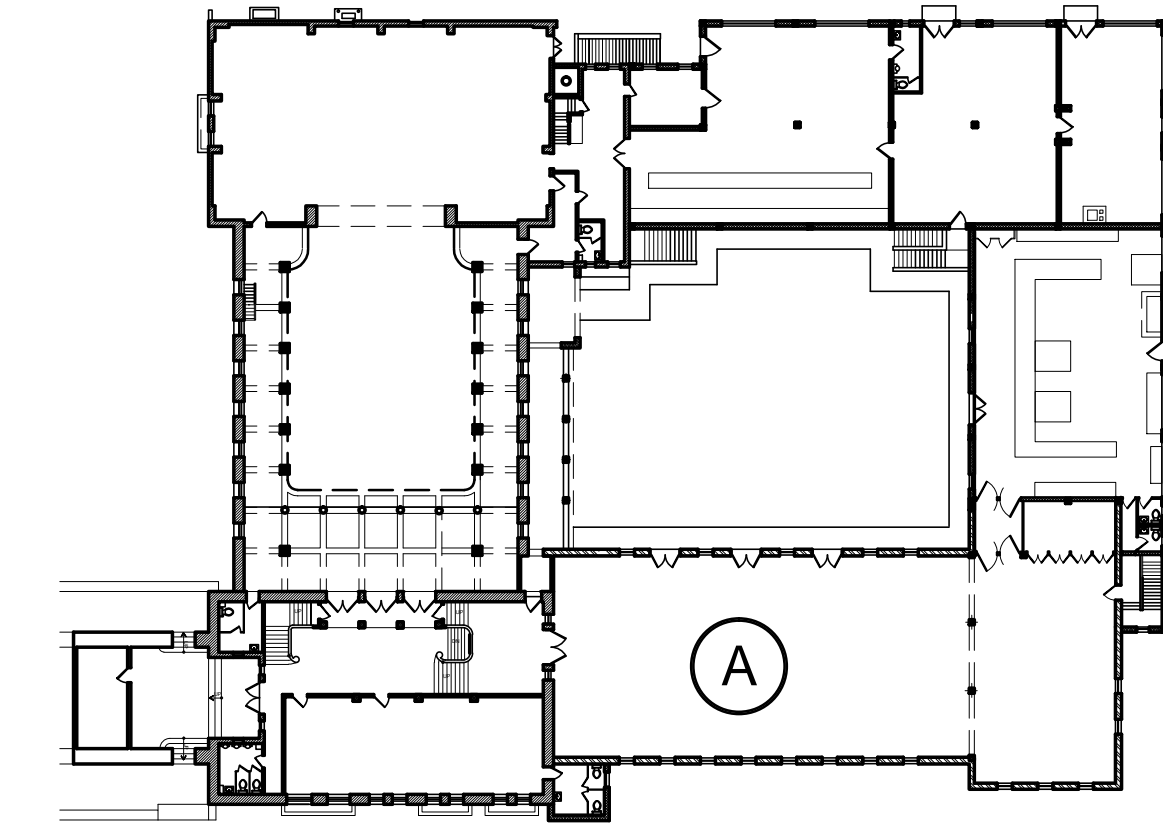

PLAN KEY

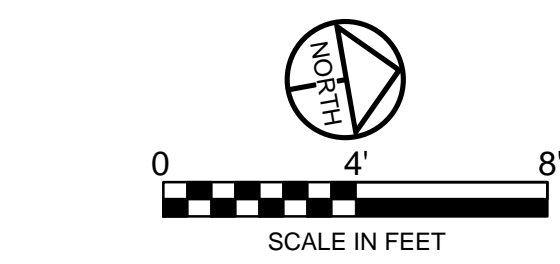

WALL LEGEND	
	ORIGINAL - 1911
	ADDITION - 1955
	ADDITIONS - POST 1955

Dale F. Zinn and Associates, Architects
P.O. Box 756
Santa Fe, New Mexico 87504
(505) 982-8690
DFZinn@aol.com

AS-BUILT LAYOUT
SCOTTISH RITE TEMPLE
463 PASEO DE PERALTA
SANTA FE COUNTY
SANTA FE, NEW MEXICO

FLOOR PLAN
DINING ROOM

DATE:	09/01/15	LA	DZ
DRAWN BY:			
CHECKED:			
			S-R_TEMPLE-01.DWG

REVISIONS:	ID	DESC.	DATE

SHEET
MT3