



(A) KITCHEN FLOOR PLAN
SCALE: 1/4" = 1'-0"

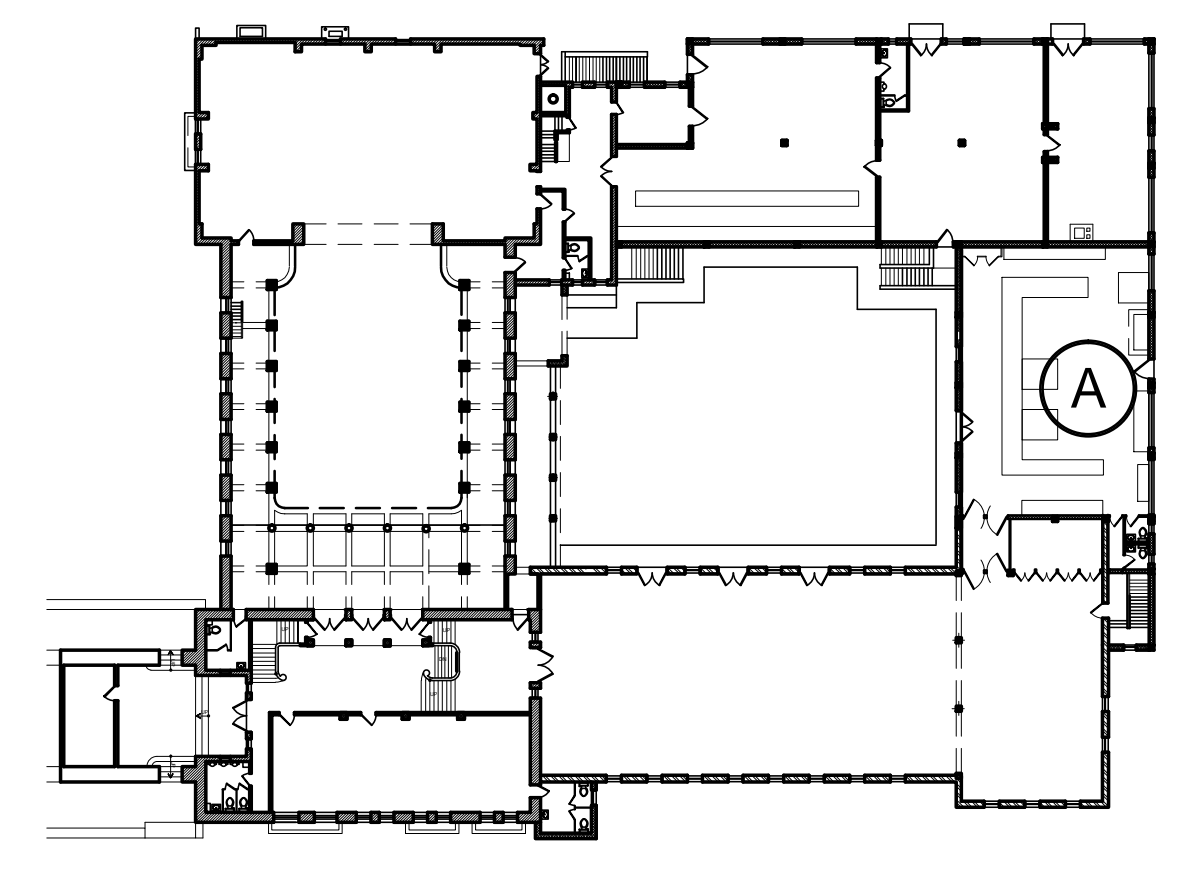

PLAN KEY

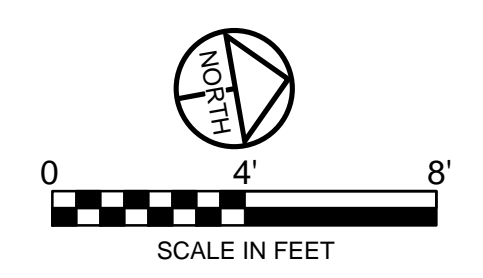

WALL LEGEND

	ORIGINAL - 1911
	ADDITION - 1955
	ADDITIONS - POST 1955

Dale F. Zinn and Associates, Architects		P.O. Box 756 Santa Fe, New Mexico 87504 (505) 982-8690 DFZinn@aol.com	
AS-BUILT LAYOUT		SCOTTISH RITE TEMPLE 463 PASEO DE PERALTA SANTA FE COUNTY SANTA FE, NEW MEXICO	
FLOOR PLAN KITCHEN			
DATE:	09/01/15	DRAWN BY:	LA
REVISIONS:	DATE	CHECKED:	DZ
ID	DESC.		
S-R_TEMPLE-01.DWG			
SHEET			
MT4			